

Floor 26

Suite 2650

~4,743 SQFT

High-Rise – As Built

- 9 Private Offices (Exterior)
- 1 Executive Office or Meeting Room
- 1 Large Conference Room
- 8-10 Workstations
- 1 Reception Area
- 1 Break / Copy Room
- 1 IT Room
- 1 Storage Closet

Jim Collins

jcollins@shorenstein.com

(415) 352-7239


Lic. #00860991

Tom McDonnell

tmcdonnell@shorenstein.com

(415) 772-7086

Lic. #01011145

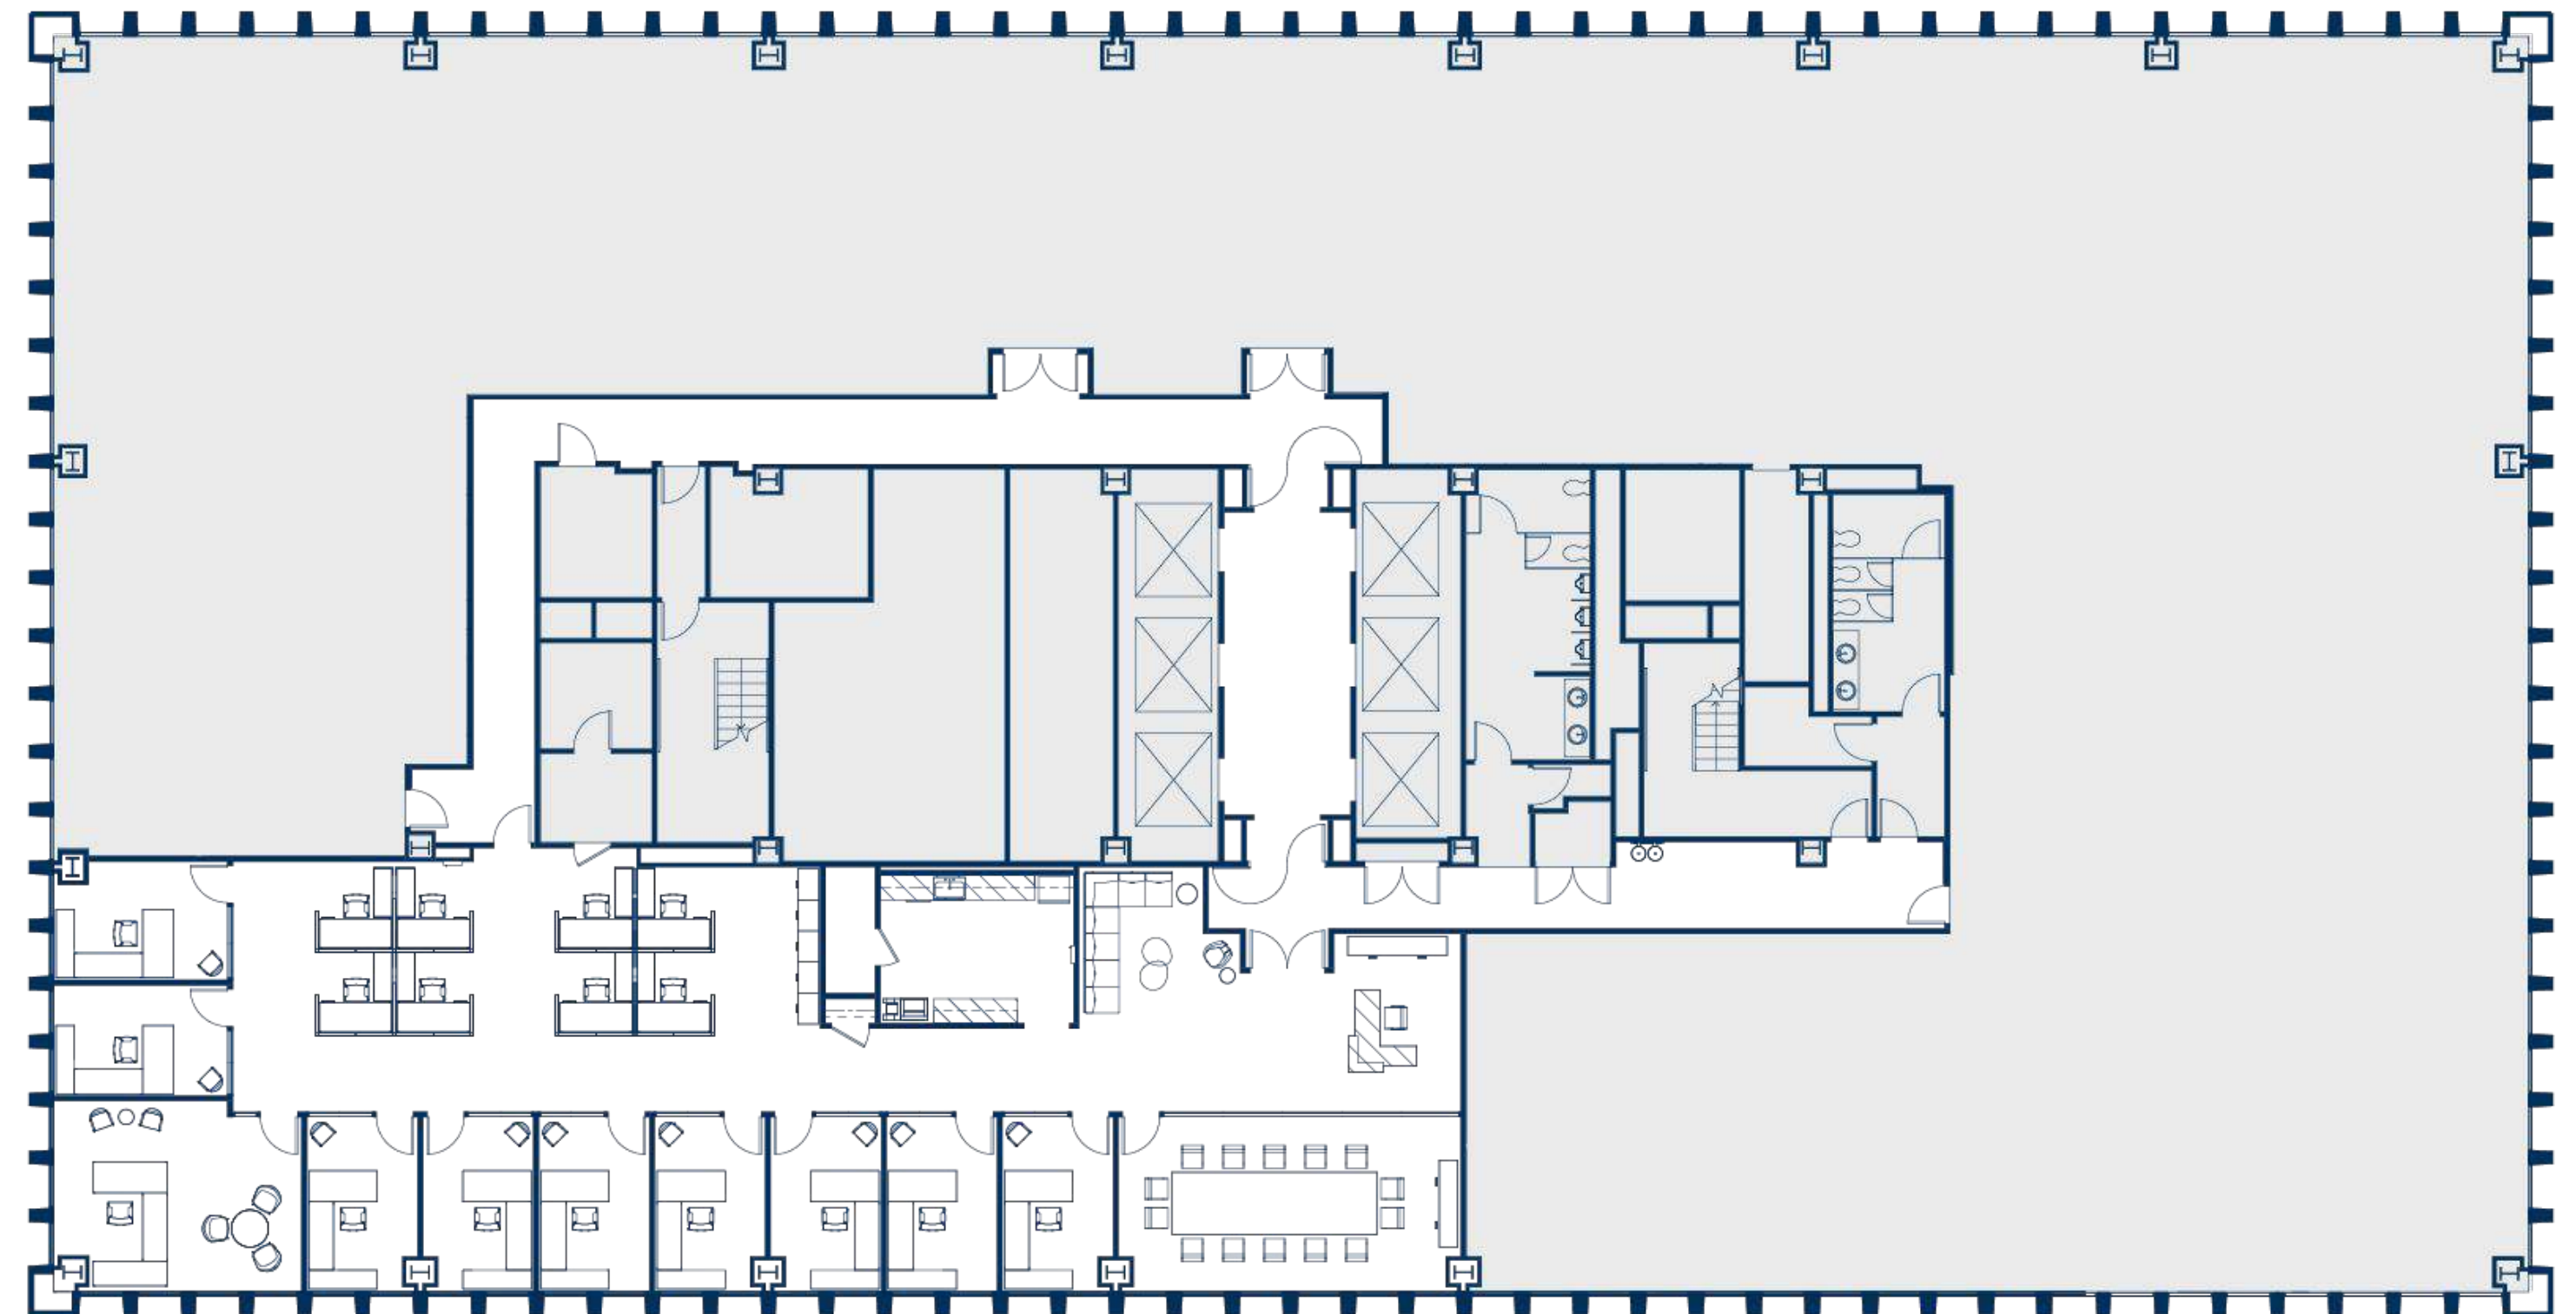

DAVIS STREET



50 California St. San Francisco, CA 94104

